


This document was produced by scanning the original publication.  
Ce document est le produit d'une numérisation par balayage de la publication originale.

Refer to this map as:  
74 E  
EDITION 2 ASE  
SERIES A 502

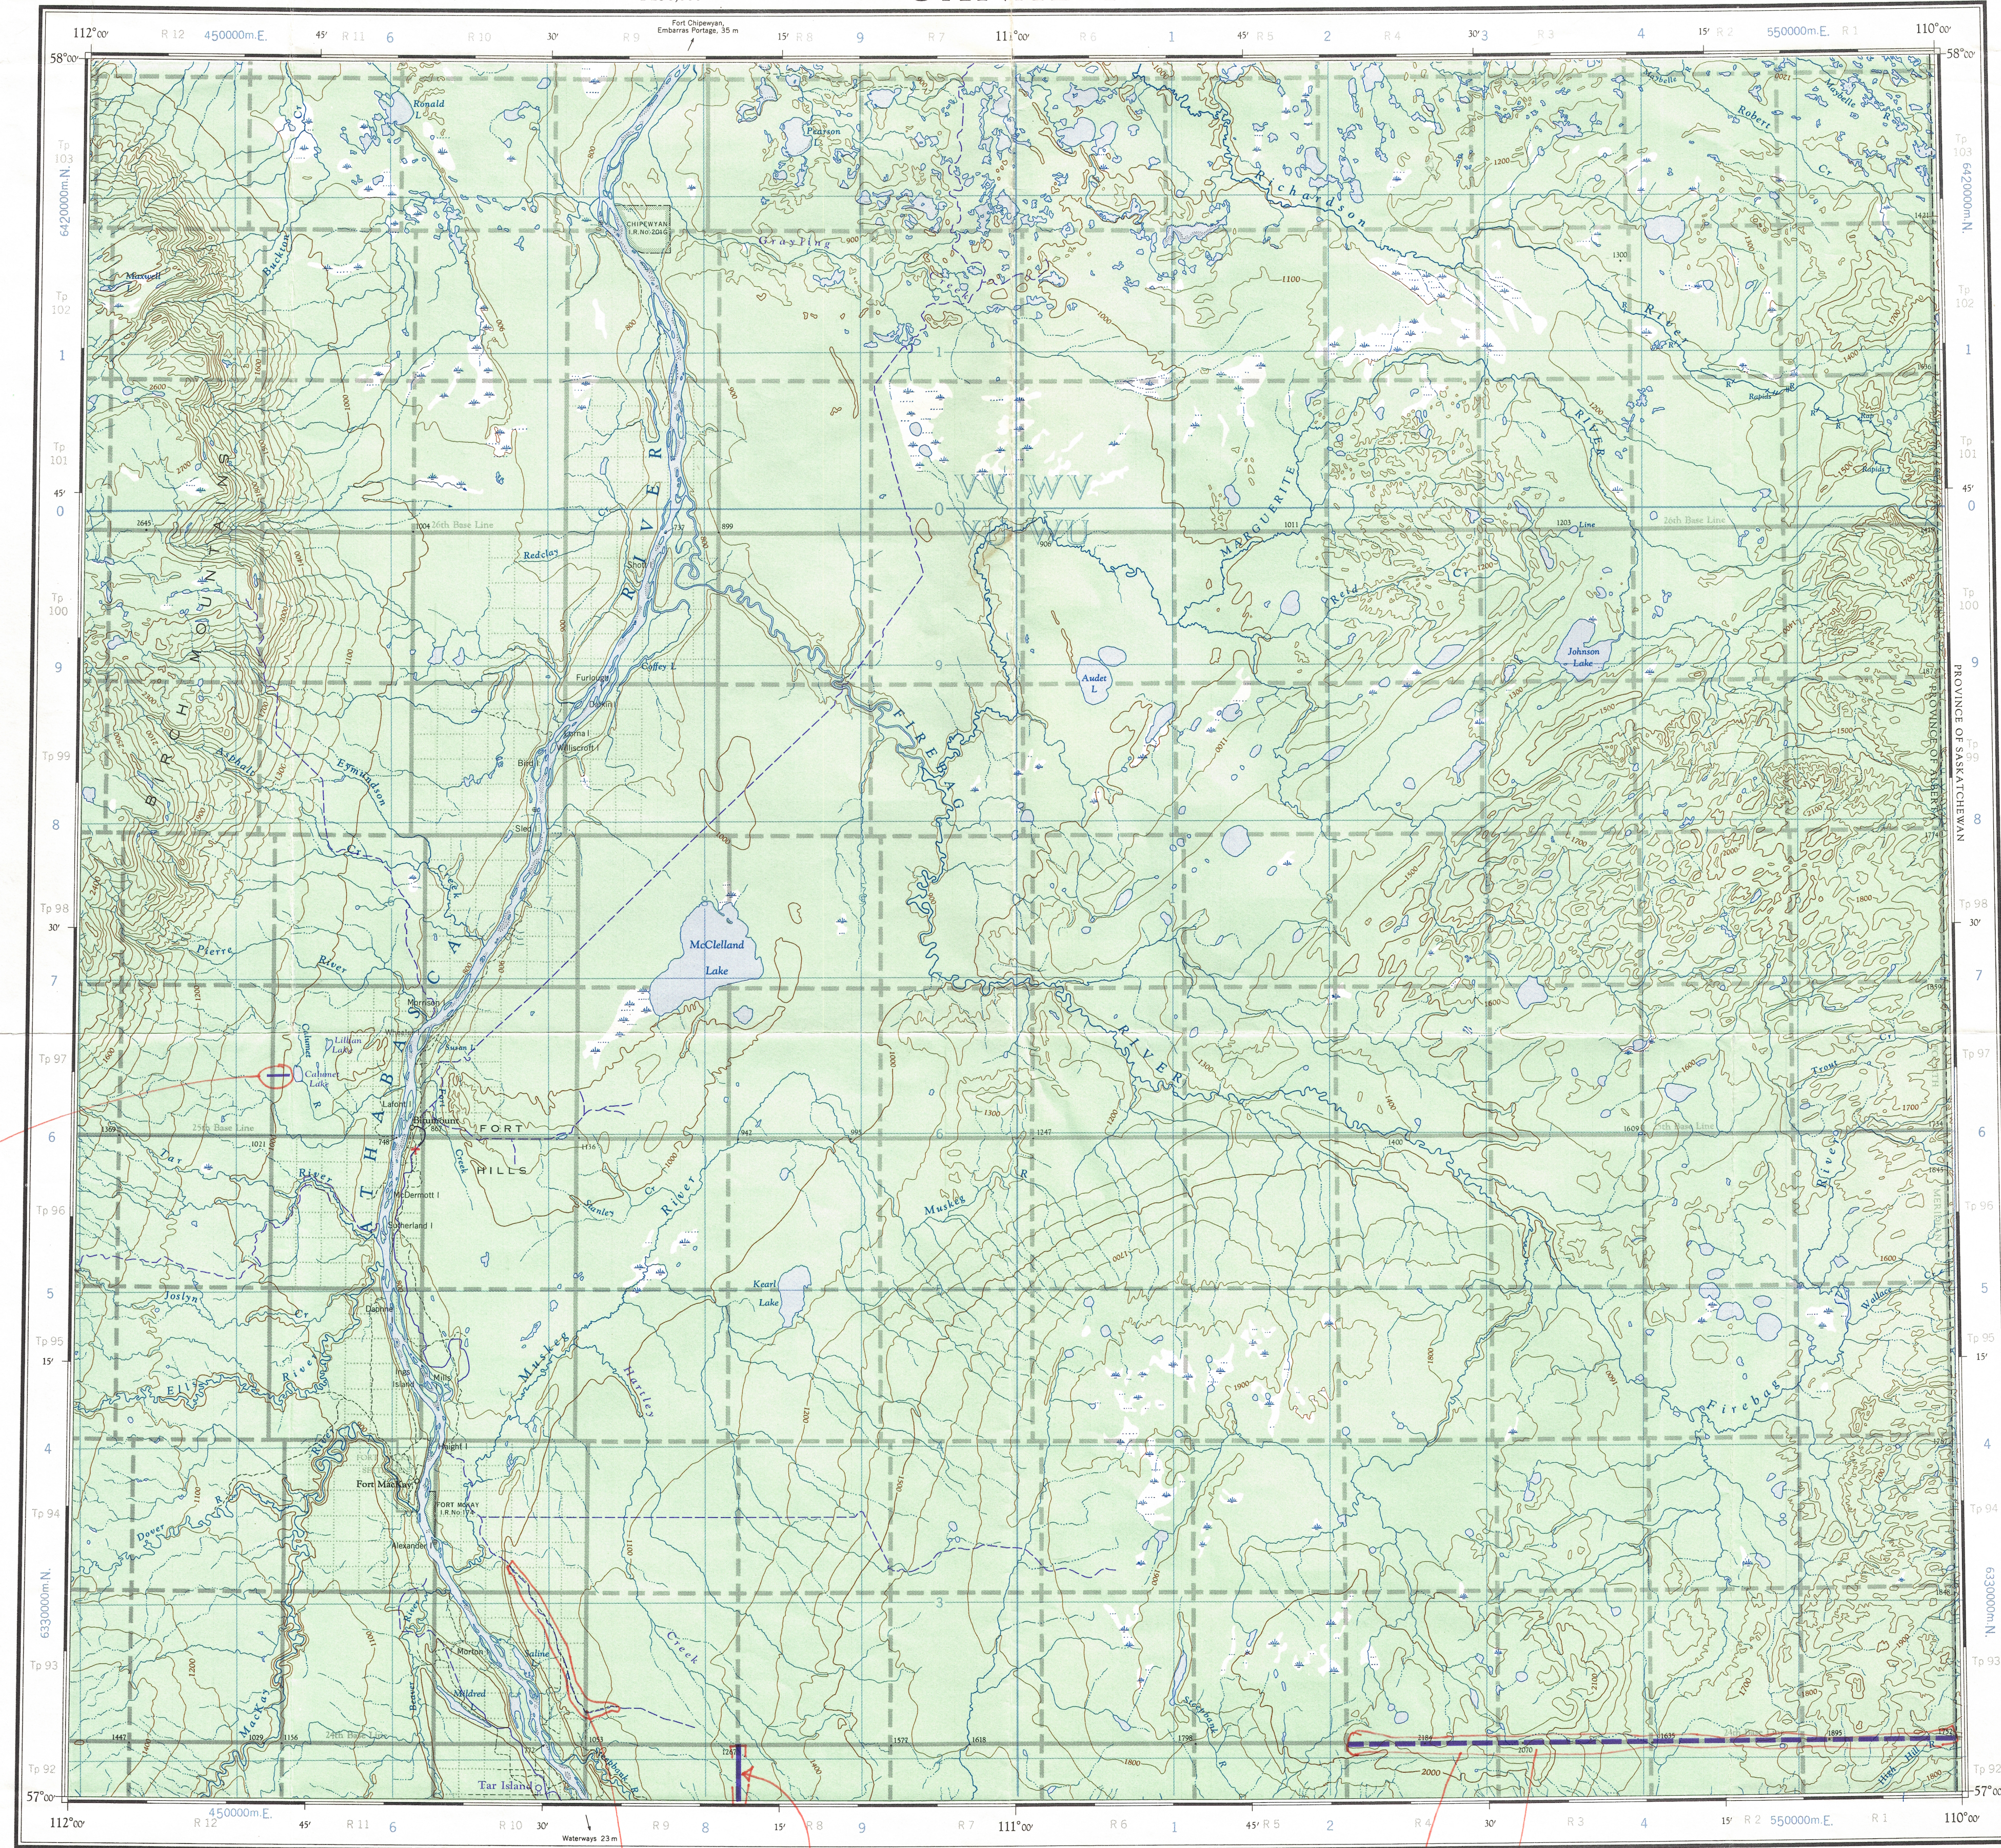

Local surface, dry weather  
No ground reference shown  
of river

100,000 M. SQUARE IDENTIFICATION

GRID ZONE DESIGNATION	VU6259
12V	64

TO GIVE A REFERENCE TO NEAREST 1000 METRES

EXAMPLE: LANDING GROUND

SQUARE: Read letters of 100,000 m. square VU

EASTING: Read number on grid line immediately to left of point. Estimate tenths of a square from this line eastward to point.

NORTHING: Read number on grid line immediately below point. Estimate tenths of a square from this line northward to point.

MILITARY GRID REFERENCE (to nearest 100 metres) VU6259

If reporting beyond 18° in any direction, prefix Grid Zone Designation as: 12V VU6259

TEN THOUSAND METRE  
UNIVERSAL TRANSVERSE MERCATOR GRID  
ZONE 12

TOPOGRAPHICAL SURVEY DIRECTORATE  
SERVICE TOPOGRAPHIQUE  
DATE 6-01-86  
O.C. APPROVES RELEASE  
C.O. APPROVE

BITUMOUNT  
74 E  
EDITION 2  
(1967)  
REPRINT

THE DECLINATION OF THE COMPASS NEEDLE 1958

The declination of the compass needle at any place along a red line is the declination given on that red line. At other places the declination is between those given on the neighbouring red lines that at the place marked A, the declination is between 25°00' E and 25°30' E. The declination of the compass needle is decreasing 0.5 min. annually.

Produced and Printed by the SURVEYS AND MAPPING BRANCH, DEPARTMENT OF MINES AND TECHNICAL SURVEYS, 1954, Revised 1958.  
Interim corrections 1967 - may not be as accurate as original detail.

Universal Transverse Mercator Projection.

Contour interval 100 Feet  
Elevations in Feet above Mean Sea Level  
North American Datum 1927

Scale 1:250,000  
1 inch to 4 Miles Approximately

1 X TRAIL ALONG PURPLE ROAD  
1 X BLACK SCREEN ALONG PURPLE  
1 X BLACK SCREEN ALONG PURPLE  
1 X BLACK SCREEN ALONG PURPLE

REFERENCE

Road, Hard Surface, All Weather	More than 2 Lanes	2 Lanes	1 Lane	Less than 1 Lane
Road, Loose Surface	All Weather	All Weather	Dry Weather	Dry Weather
Wagon Road, Cart Track, etc.	2 Lanes or more	Less than 2 Lanes	Footpath or Trail	Abandoned
Railway, Standard Gauge	Multiple Track	Single Track	Station	Stop
Boundary, International	.....	.....	.....	.....
Boundary, Provincial	.....	.....	.....	.....
Boundary, Indian Res., Park, etc.	.....	.....	.....	.....
Boundary, Township, Surveyed	.....	.....	.....	.....
Boundary, Township, Unsurveyed	.....	.....	.....	.....
Section Line	.....	.....	.....	.....

Contours: elevation ..... 1000 ..... 2000 ..... 13100